

# Work Order ID 139465

**\*139465\***

Page 1

Monday, November 30, 2015 11:44:25 AM

Item ID: D3707-3

Accept

**\*N900040100\***

Setup Start **\*NS1\***

Revision ID:

Stop **\*NS2\***

Item Name: Mounting Lug

Start Date: 11/30/2015 Start Qty: 400 **\*4\***

Cust Item ID:

Required Date: 11/30/2015 Req'd Qty: 400 **\*4\***

Customer:

Reference:

Approvals: Process Plan: MLS Date: DEC 01 2015 Tooling: \_\_\_\_\_ Date: \_\_\_\_\_

Run Start **\*NR1\***

QC: \_\_\_\_\_ Date: \_\_\_\_\_ SPC (Y/N): \_\_\_\_\_ Date: \_\_\_\_\_

Stop **\*NR2\***

| Sequence ID/<br>Work Center ID | Operation<br>Description | Set Up/<br>Run Hours | Tool ID | Tool # | Plan<br>Code | Accept<br>Qty | Reject<br>Qty | Reject<br>Number | Insp.<br>Stamp |
|--------------------------------|--------------------------|----------------------|---------|--------|--------------|---------------|---------------|------------------|----------------|
|--------------------------------|--------------------------|----------------------|---------|--------|--------------|---------------|---------------|------------------|----------------|

| Draw Nbr | Revision Nbr |
|----------|--------------|
| D3707    | D            |

100 0.00

**\*100\***

BAND SAW

Bandsaw

Memo

Jeaspa Bandsaw

Cut blank 2.700" long

110

**\*110\***

HAAS CNC VERTICAL MACHINING #1

HAAS 1

Memo

HAAS CNC vertical machine #1

1- Mill as per Folio FA738 Rev: AA &  
Dwg D3707 Rev: D  
2-Deburr per dwg D3707

120

**\*120\***

QC2- Inspect parts off machine FAI/FAIB

QC

Memo

Quality Control

0.00

0.00

6 8 SL16-1-14

6 SL16-1-14

6 SL16-1-14

DQA: \_\_\_\_\_ Date: \_\_\_\_\_



## WORK ORDER NON-CONFORMANCE / UPDATE

QA Closed: \_\_\_\_\_ Date: \_\_\_\_\_

Work Order update only ☐

|   |  |   |  |   |  |   |   |   |  |   |  |
|---|--|---|--|---|--|---|---|---|--|---|--|
| Work Order: _____<br><br>Part No. _____<br><br>NCR No. _____   |  | <b>DISPOSITION</b><br><br>Rework <input type="checkbox"/><br>Scrap <input type="checkbox"/><br>Use-as-is <input type="checkbox"/><br>Suspected Unapproved <input type="checkbox"/>   |  | <b>AGAINST DEPARTMENT/PROCESS</b><br><br><div style="display: flex; justify-content: space-between;"> <div>           Skid-tube <input type="checkbox"/><br/>           Machining <input type="checkbox"/><br/>           Thermoforming <input type="checkbox"/><br/>           Large Fab <input type="checkbox"/> </div> <div>           Cross tube <input type="checkbox"/><br/>           Small Fab <input type="checkbox"/><br/>           Finishing <input type="checkbox"/><br/>           Composite <input type="checkbox"/> </div> <div>           Water Jet <input type="checkbox"/><br/>           Prod. Eng. Coord. <input type="checkbox"/><br/>           Rec/Store/Packaging <input type="checkbox"/><br/>           Supplier <input type="checkbox"/> </div> <div>           Engineering <input type="checkbox"/><br/>           Quality <input type="checkbox"/><br/>           Other <input type="checkbox"/> </div> </div> |  |   |   |   |  |   |  |
| Date :   |  | Step #:   |  | QTY Effective :   |  |   | MRB (QSI042) Approval<br><br><br>Completed By<br><br><br>Lead hand / Supervisor<br>Approval Verification<br><br><br>QC / QA Coordinator<br>Approval |   |  |   |  |
| Description Work Order Deviation   |  |   |  | Disposition   |  |   |   |   |  |   |  |
|   |  |   |  |   |  |   |   |   |  |   |  |
| <b>Root Cause</b><br>Environment <input type="checkbox"/><br>Design <input type="checkbox"/><br>Doc/Data <input type="checkbox"/><br>Equip/Tooling <input type="checkbox"/><br>Handling/Pre <input type="checkbox"/><br>Material <input type="checkbox"/><br>Internal Transport <input type="checkbox"/><br>Tribal Knowledge <input type="checkbox"/><br>LOA <input type="checkbox"/><br>Substation <input type="checkbox"/><br>Past Expiry Date <input type="checkbox"/><br>Misidentified <input type="checkbox"/> |  | No Re-verification <input type="checkbox"/><br>Operator <input type="checkbox"/><br>Offset/Setup <input type="checkbox"/><br>Supplier <input type="checkbox"/><br>Training <input type="checkbox"/><br>Use for Testing <input type="checkbox"/><br>Poor Information <input type="checkbox"/><br>Rushing <input type="checkbox"/><br>Product Improvement <input type="checkbox"/><br>Process Improvement <input type="checkbox"/><br>Manufacturing Process <input type="checkbox"/><br>Past Due <input type="checkbox"/> |  | <b>FAULT CATEGORY</b><br>Pressure/Forced <input type="checkbox"/><br>Bending <input type="checkbox"/><br>Centre Not Concentric <input type="checkbox"/><br>Cracks <input type="checkbox"/><br>Crimp/Kink/Ripple/Wave <input type="checkbox"/><br>Cuffs <input type="checkbox"/><br>Crushing <input type="checkbox"/><br>Heat Treat <input type="checkbox"/><br>Wave/Twist in Tube <input type="checkbox"/><br>Marks/Chatter <input type="checkbox"/>   |  | Temperature/Cure <input type="checkbox"/><br>Set-up <input type="checkbox"/><br>BOM/Route <input type="checkbox"/><br>Broken/Damage/Defect <input type="checkbox"/><br>Inspection Incomplete/Unqualified <input type="checkbox"/><br>Contamination <input type="checkbox"/><br>Countersink <input type="checkbox"/><br>Cut Too Short <input type="checkbox"/><br>Instructions Incomplete/Unclear <input type="checkbox"/><br>Drill Holes <input type="checkbox"/> |   | Power Loss/Surge <input type="checkbox"/><br>Folio/Program <input type="checkbox"/><br>Grain <input type="checkbox"/><br>Weld <input type="checkbox"/><br>Wrong Stock Pulled <input type="checkbox"/><br>Out of Sequence <input type="checkbox"/><br>Off-set <input type="checkbox"/><br>Misabeled <input type="checkbox"/><br>Fit/Function <input type="checkbox"/><br>Misaligned/off center <input type="checkbox"/> |  | Positioned Wrong <input type="checkbox"/><br>Outside Dimensions <input type="checkbox"/><br>Over/Under tolerance <input type="checkbox"/><br>Part Incorrect <input type="checkbox"/><br>Part Lost/Missing <input type="checkbox"/><br>Part Moved <input type="checkbox"/><br>Drawing <input type="checkbox"/><br>Finish <input type="checkbox"/><br>Misread <input type="checkbox"/><br>Turning Sequence <input type="checkbox"/> |  |
|   |  |   |  | OTHER : <input type="checkbox"/>   |  |   |   |   |  |   |  |

# Work Order ID 139465

**\*139465\***

Page 2

Monday, November 30, 2015 11:44:25 AM

Item ID: D3707-3 Accept **\*N900040100\*** Setup Start **\*NS1\***  
Revision ID: Stop **\*NS2\***  
Item Name: Mounting Lug  
Start Date: 11/30/2015 Start Qty: 4.00 **\*4\*** Cust Item ID:  
Required Date: 11/30/2015 Req'd Qty: 4.00 **\*4\*** Customer:  
Reference:

Approvals: Process Plan: \_\_\_\_\_ Date: \_\_\_\_\_ Tooling: \_\_\_\_\_ Date: \_\_\_\_\_ Run Start **\*NR1\***  
QC: \_\_\_\_\_ Date: \_\_\_\_\_ SPC (Y/N): \_\_\_\_\_ Date: \_\_\_\_\_ Stop **\*NR2\***

| Sequence ID/<br>Work Center ID | Operation<br>Description                                            | Set Up/<br>Run Hours | Tool ID | Tool # | Plan<br>Code | Accept<br>Qty | Reject<br>Qty | Reject<br>Number | Insp.<br>Stamp                |
|--------------------------------|---------------------------------------------------------------------|----------------------|---------|--------|--------------|---------------|---------------|------------------|-------------------------------|
| 130                            | QC8- Inspect parts - second check                                   | 0.00                 |         |        |              |               |               |                  | DAS<br>44<br>9-89 15/01/14    |
| <b>*130*</b>                   |                                                                     |                      |         |        |              | 6             | Ø             |                  |                               |
| QC                             | Memo                                                                | 0.00                 |         |        |              |               |               |                  |                               |
| Quality Control                |                                                                     |                      |         |        |              |               |               |                  |                               |
| 140                            | Identify as per dwg & Stock Location: <del>Stock</del> <b>Stock</b> | 0.00                 |         |        |              |               |               |                  |                               |
| <b>*140*</b>                   |                                                                     |                      |         |        |              | 6             |               |                  | DAS<br>6<br>9-89 JAN 1 8 2016 |
| Packaging                      | Memo                                                                | 0.00                 |         |        |              |               |               |                  |                               |
| Packaging                      |                                                                     |                      |         |        |              |               |               |                  |                               |
| 150                            | QC21- Final Inspection - Work Order Release                         | 0.00                 |         |        |              |               |               |                  |                               |
| <b>*150*</b>                   |                                                                     |                      |         |        |              |               |               |                  | JAN 1 8 2016                  |
| QC                             | Memo                                                                | 0.00                 |         |        |              |               |               |                  |                               |
| Quality Control                |                                                                     |                      |         |        |              |               |               |                  |                               |

**MCS** JAN 1 8 2016

DQA: \_\_\_\_\_ Date: \_\_\_\_\_



## WORK ORDER NON-CONFORMANCE / UPDATE

QA Closed: \_\_\_\_\_ Date: \_\_\_\_\_

Work Order update only ☐

|   |  |   |  |   |  |  |   |  |  |
|---|--|---|--|---|--|--|---|--|--|
| Work Order: _____<br><br>Part No. _____<br><br>NCR No. _____   |  | <b>DISPOSITION</b><br><br>Rework <input type="checkbox"/><br>Scrap <input type="checkbox"/><br>Use-as-is <input type="checkbox"/><br>Suspected Unapproved <input type="checkbox"/>   |  | <b>AGAINST DEPARTMENT/PROCESS</b><br><br><div style="display: flex; justify-content: space-between;"> <div>           Skid-tube <input type="checkbox"/><br/>           Machining <input type="checkbox"/><br/>           Thermoforming <input type="checkbox"/><br/>           Large Fab <input type="checkbox"/> </div> <div>           Cross tube <input type="checkbox"/><br/>           Small Fab <input type="checkbox"/><br/>           Finishing <input type="checkbox"/><br/>           Composite <input type="checkbox"/> </div> <div>           Water Jet <input type="checkbox"/><br/>           Prod. Eng. Coord. <input type="checkbox"/><br/>           Rec/Store/Packaging <input type="checkbox"/><br/>           Supplier <input type="checkbox"/> </div> <div>           Engineering <input type="checkbox"/><br/>           Quality <input type="checkbox"/><br/>           Other <input type="checkbox"/> </div> </div>   |  |  |   |  |  |
| Date :   |  | Step #:   |  | QTY Effective :   |  |  | MRB (QSI042) Approval<br><br><br>Completed By<br><br><br>Lead hand / Supervisor<br>Approval Verification<br><br><br>QC / QA Coordinator<br>Approval |  |  |
| Description Work Order Deviation   |  |   |  | Disposition   |  |  |   |  |  |
|   |  |   |  |   |  |  |   |  |  |
|   |  |   |  |   |  |  |   |  |  |
| <b>Root Cause</b><br><div style="display: flex;"> <div style="width: 50%;">           Environment <input type="checkbox"/><br/>           Design <input type="checkbox"/><br/>           Doc/Data <input type="checkbox"/><br/>           Equip/Tooling <input type="checkbox"/><br/>           Handling/Pre <input type="checkbox"/><br/>           Material <input type="checkbox"/><br/>           Internal Transport <input type="checkbox"/><br/>           Tribal Knowledge <input type="checkbox"/><br/>           LOA <input type="checkbox"/><br/>           Substation <input type="checkbox"/><br/>           Past Expiry Date <input type="checkbox"/><br/>           Misidentified <input type="checkbox"/> </div> <div style="width: 50%;">           No Re-verification <input type="checkbox"/><br/>           Operator <input type="checkbox"/><br/>           Offset/Setup <input type="checkbox"/><br/>           Supplier <input type="checkbox"/><br/>           Training <input type="checkbox"/><br/>           Use for Testing <input type="checkbox"/><br/>           Poor Information <input type="checkbox"/><br/>           Rushing <input type="checkbox"/><br/>           Product Improvement <input type="checkbox"/><br/>           Process Improvement <input type="checkbox"/><br/>           Manufacturing Process <input type="checkbox"/><br/>           Past Due <input type="checkbox"/> </div> </div> |  | <b>FAULT CATEGORY</b><br><div style="display: flex;"> <div style="width: 50%;">           Pressure/Forced <input type="checkbox"/><br/>           Bending <input type="checkbox"/><br/>           Centre Not Concentric <input type="checkbox"/><br/>           Cracks <input type="checkbox"/><br/>           Crimp/Kink/Ripple/Wave <input type="checkbox"/><br/>           Cuffs <input type="checkbox"/><br/>           Crushing <input type="checkbox"/><br/>           Heat Treat <input type="checkbox"/><br/>           Wave/Twist in Tube <input type="checkbox"/><br/>           Marks/Chatter <input type="checkbox"/> </div> <div style="width: 50%;">           Temperature/Cure <input type="checkbox"/><br/>           Set-up <input type="checkbox"/><br/>           BOM/Route <input type="checkbox"/><br/>           Broken/Damage/Defect <input type="checkbox"/><br/>           Inspection Incomplete/Unqualified <input type="checkbox"/><br/>           Contamination <input type="checkbox"/><br/>           Countersink <input type="checkbox"/><br/>           Cut Too Short <input type="checkbox"/><br/>           Instructions Incomplete/Unclear <input type="checkbox"/><br/>           Drill Holes <input type="checkbox"/> </div> </div> |  | <div style="display: flex;"> <div style="width: 50%;">           Power Loss/Surge <input type="checkbox"/><br/>           Folio/Program <input type="checkbox"/><br/>           Grain <input type="checkbox"/><br/>           Weld <input type="checkbox"/><br/>           Wrong Stock Pulled <input type="checkbox"/><br/>           Out of Sequence <input type="checkbox"/><br/>           Off-set <input type="checkbox"/><br/>           Mislabeled <input type="checkbox"/><br/>           Fit/Function <input type="checkbox"/><br/>           Misaligned/off center <input type="checkbox"/> </div> <div style="width: 50%;">           Positioned Wrong <input type="checkbox"/><br/>           Outside Dimensions <input type="checkbox"/><br/>           Over/Under tolerance <input type="checkbox"/><br/>           Part Incorrect <input type="checkbox"/><br/>           Part Lost/Missing <input type="checkbox"/><br/>           Part Moved <input type="checkbox"/><br/>           Drawing <input type="checkbox"/><br/>           Finish <input type="checkbox"/><br/>           Misread <input type="checkbox"/><br/>           Turning Sequence <input type="checkbox"/> </div> </div> |  |  |   |  |  |
| OTHER : <input type="checkbox"/>   |  |   |  |   |  |  |   |  |  |

# Picklist Print

Monday, November 30, 2015 11:44:24 AM

Page 1

Work Order ID: 139465

**\*139465\***

Parent Item: D3707-3

**\*D3707-3\***

Parent Item Name: Mounting Lug

Start Date: 11/30/2015

Required Date: 11/30/2015

Start Qty: 4.00

Required Qty: 4.00

Comments: IPP Rev:A New Issue 08-04-16 JLM Verified By:EC

| Component Item ID/<br>Item Name | Replacement<br>Item ID | Mfg/<br>Purch | Bin<br>Item | Primary<br>Location | Last<br>Location | Route<br>Seq ID | Unit of<br>Measure | Qty on<br>Hand | Qty per Kit | Total<br>Qty | Qty<br>Issued | Date<br>Issued | Status |
|---------------------------------|------------------------|---------------|-------------|---------------------|------------------|-----------------|--------------------|----------------|-------------|--------------|---------------|----------------|--------|
| MDELRINB1.250X2.50<br>0         |                        | Purchased     |             | No                  |                  |                 | f                  | 13.0000        |             | 0.968421     |               |                |        |

**\*MDFI RINB1 250X2 500\***

**\*\***

Delrin Bar 1.250"X 2.500"

Location

Loc Qty

Loc Code

MAT011

13

m126395

13

1,42

DQA: \_\_\_\_\_ Date: \_\_\_\_\_



## WORK ORDER NON-CONFORMANCE / UPDATE

QA Closed: \_\_\_\_\_ Date: \_\_\_\_\_

Work Order update only ☐

|                                                              |                                                |   |                                                            |   |                                               |  |   |  |  |
|--------------------------------------------------------------|------------------------------------------------|---|------------------------------------------------------------|---|-----------------------------------------------|--|---|--|--|
| Work Order: _____<br><br>Part No. _____<br><br>NCR No. _____ |                                                | <b>DISPOSITION</b><br><br>Rework <input type="checkbox"/><br>Scrap <input type="checkbox"/><br>Use-as-is <input type="checkbox"/><br>Suspected Unapproved <input type="checkbox"/> |                                                            | <b>AGAINST DEPARTMENT/PROCESS</b><br><br><div style="display: flex; justify-content: space-between;"> <div>             Skid-tube <input type="checkbox"/><br/>             Machining <input type="checkbox"/><br/>             Thermoforming <input type="checkbox"/><br/>             Large Fab <input type="checkbox"/> </div> <div>             Cross tube <input type="checkbox"/><br/>             Small Fab <input type="checkbox"/><br/>             Finishing <input type="checkbox"/><br/>             Composite <input type="checkbox"/> </div> <div>             Water Jet <input type="checkbox"/><br/>             Prod. Eng. Coord. <input type="checkbox"/><br/>             Rec/Store/Packaging <input type="checkbox"/><br/>             Supplier <input type="checkbox"/> </div> <div>             Engineering <input type="checkbox"/><br/>             Quality <input type="checkbox"/><br/>             Other <input type="checkbox"/> </div> </div> |                                               |  |   |  |  |
| Date :                                                       |                                                | Step #:   |                                                            | QTY Effective :   |                                               |  | MRB (QSI042) Approval<br><br><br>Completed By<br><br><br>Lead hand / Supervisor<br>Approval Verification<br><br><br>QC / QA Coordinator<br>Approval |  |  |
| Description Work Order Deviation                             |                                                |   |                                                            | Disposition   |                                               |  |   |  |  |
|                                                              |                                                |   |                                                            |   |                                               |  |   |  |  |
|                                                              |                                                |   |                                                            |   |                                               |  |   |  |  |
| Root Cause                                                   |                                                | FAULT CATEGORY   |                                                            |   |                                               |  |   |  |  |
| Environment <input type="checkbox"/>                         | No Re-verification <input type="checkbox"/>    | Pressure/Forced <input type="checkbox"/>   | Temperature/Cure <input type="checkbox"/>                  | Power Loss/Surge <input type="checkbox"/>   | Positioned Wrong <input type="checkbox"/>     |  |   |  |  |
| Design <input type="checkbox"/>                              | Operator <input type="checkbox"/>              | Bending <input type="checkbox"/>   | Set-up <input type="checkbox"/>                            | Folio/Program <input type="checkbox"/>   | Outside Dimensions <input type="checkbox"/>   |  |   |  |  |
| Doc/Data <input type="checkbox"/>                            | Offset/Setup <input type="checkbox"/>          | Centre Not Concentric <input type="checkbox"/>   | BOM/Route <input type="checkbox"/>                         | Grain <input type="checkbox"/>   | Over/Under tolerance <input type="checkbox"/> |  |   |  |  |
| Equip/Tooling <input type="checkbox"/>                       | Supplier <input type="checkbox"/>              | Cracks <input type="checkbox"/>   | Broken/Damage/Defect <input type="checkbox"/>              | Weld <input type="checkbox"/>   | Part Incorrect <input type="checkbox"/>       |  |   |  |  |
| Handling/Pre <input type="checkbox"/>                        | Training <input type="checkbox"/>              | Crimp/Kink/Ripple/Wave <input type="checkbox"/>   | Inspection Incomplete/Unqualified <input type="checkbox"/> | Wrong Stock Pulled <input type="checkbox"/>   | Part Lost/Missing <input type="checkbox"/>    |  |   |  |  |
| Material <input type="checkbox"/>                            | Use for Testing <input type="checkbox"/>       | Cuffs <input type="checkbox"/>   | Contamination <input type="checkbox"/>                     | Out of Sequence <input type="checkbox"/>   | Part Moved <input type="checkbox"/>           |  |   |  |  |
| Internal Transport <input type="checkbox"/>                  | Poor Information <input type="checkbox"/>      | Crushing <input type="checkbox"/>   | Countersink <input type="checkbox"/>                       | Off-set <input type="checkbox"/>   | Drawing <input type="checkbox"/>              |  |   |  |  |
| Tribal Knowledge <input type="checkbox"/>                    | Rushing <input type="checkbox"/>               | Heat Treat <input type="checkbox"/>   | Cut Too Short <input type="checkbox"/>                     | Mislabeled <input type="checkbox"/>   | Finish <input type="checkbox"/>               |  |   |  |  |
| LOA <input type="checkbox"/>                                 | Product Improvement <input type="checkbox"/>   | Wave/Twist in Tube <input type="checkbox"/>   | Instructions Incomplete/Unclear <input type="checkbox"/>   | Fit/Function <input type="checkbox"/>   | Misread <input type="checkbox"/>              |  |   |  |  |
| Substation <input type="checkbox"/>                          | Process Improvement <input type="checkbox"/>   | Marks/Chatter <input type="checkbox"/>   | Drill Holes <input type="checkbox"/>                       | Misaligned/off center <input type="checkbox"/>   | Turning Sequence <input type="checkbox"/>     |  |   |  |  |
| Past Expiry Date <input type="checkbox"/>                    | Manufacturing Process <input type="checkbox"/> | OTHER : _____   |                                                            |   |                                               |  |   |  |  |
| Misidentified <input type="checkbox"/>                       | Past Due <input type="checkbox"/>              |   |                                                            |   |                                               |  |   |  |  |

|                                  |                         |                             |
|----------------------------------|-------------------------|-----------------------------|
| <b>DART AEROSPACE LTD</b>        |                         | <b>Work Order:</b> 139465   |
| <b>Description:</b> Mounting Lug |                         | <b>Part Number:</b> D3707-3 |
| <b>Inspection Dwg:</b> D3707     | <b>Rev:</b> 8 <i>DA</i> | <b>Page 1 of 1</b>          |

### FIRST ARTICLE INSPECTION CHECKLIST

| Drawing Dimension | Tolerance                              | Actual Dimension | Accept | Reject | Method of Inspection | Comments |
|-------------------|----------------------------------------|------------------|--------|--------|----------------------|----------|
| 2.50              | +/-0.030                               | 2.502            | ✓      |        | VERW                 | SL-10    |
| 1.750             | +/-0.010                               | 1.750            | ✓      |        | -                    | -        |
| 0.38              | +/-0.030                               | .375             | ✓      |        | -                    | -        |
| R0.13             | +/-0.030                               | R.125            | ✓      |        | R-G                  | -        |
| 0.500             | +/-0.010                               | .501             | ✓      |        | VERW                 | -        |
| 1.00              | +/-0.030                               | 1.002            | ✓      |        | -                    | -        |
| Ø0.201            | +0.005/-0.001                          | .201             | ✓      |        | -                    | -        |
| Ø0.385 X 100°     | +/-0.010 X 0.5°                        | .389 X 100°      | ✓      |        | -                    | -        |
| 0.03 X 45°        | +/-0.030 X 0.5°                        | .03 X 45°        | ✓      |        | -                    | -        |
| <del>Ø0.563</del> | <del>+0.001/-0.000</del>               | N/A              |        |        |                      |          |
| R0.06             | +/-0.030                               | R.06             |        |        | R-G                  |          |
| 2.063             | +/-0.010                               | 2.066            | ✓      |        | VERW                 | -        |
| R0.48             | +/-0.030                               | R.480            | ✓      |        |                      |          |
| R0.38             | +/-0.030                               | R.380            | ✓      |        |                      |          |
| 0.125             | +/-0.010                               | .126             | ✓      |        | -                    |          |
| 1.250             | +/-0.010                               | 1.251            | ✓      |        | H-G                  |          |
| 0.500             | +/-0.010                               | .501             | ✓      |        | H-G                  |          |
| 0.98              | +/-0.030                               | .977             | ✓      |        | H-G                  |          |
| <i>Ind</i> Ø.5625 | <del>+0.050</del><br><del>-0.001</del> | .562             | ✓      |        | mic                  | SL-4     |
|                   |                                        |                  |        |        |                      |          |
|                   |                                        |                  |        |        |                      |          |
DAS

|                               |                               |                              |
|-------------------------------|-------------------------------|------------------------------|
| <b>Measured by:</b> <i>SL</i> | <b>Audited by:</b> 44<br>9-89 | <b>Preliminary Approval:</b> |
| <b>Date:</b> 16-1-14          | <b>Date:</b> 15/01/14         | <b>Date:</b>                 |


| Rev | Date     | Change          | Revised by | Approved  |
|-----|----------|-----------------|------------|-----------|
| A   | 09.05.15 | New Issue       | KJ         |           |
| B   | 13.02.27 | Dwg Rev updated | KJ         | <i>AA</i> |

SHOP COPY  
RETURN TO  
ENGINEERING  
UNCONTROLLED COPY  
SUBJECT TO AMENDMENT  
WITHOUT NOTICE  
WORK ORDER  
NO 139465.MW


15-12-01

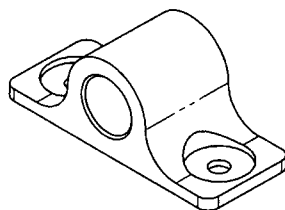

**D3707-1 MOUNTING LUG**

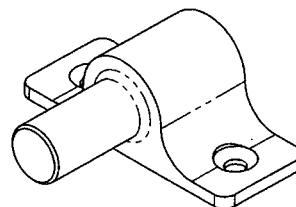

**D3707-3 MOUNTING LUG**

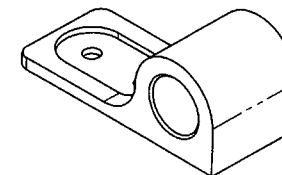



**D3707-5 MOUNTING LUG**

| D   | CHANGED TOLERANCE: $\phi 0.5635 \pm 0.0010/-0.000$ (ZN C5-2, C3-3) AND $\phi 0.5825 \pm 0.0000/-0.0010$ (ZN C2-2) WERE $\phi 0.563 \pm 0.001/-0.000$ AND $\phi 0.563 \pm 0.000/-0.001$ . REASON: MFG FACILITY. | MB | 13.01.21 |
|---|---|----|----------|
| C   | ADD -5: CBORE WAS CSINK ON -1 (ZN C7-2). REASON: PAR12-188/CIR12-4. ADD -5: REASON: D412-814 PROJECT.   | MB | 12.12.06 |
| B   | UPDATED NOTE 1 (ZN A8-1)   | MB | 08.08.22 |
| A   | NEW ISSUE   | MB | 08.04.08 |
| REV.   | DESCRIPTION   | BY | DATE     |
| DESIGN   |   |    |          |
| DRAWN   |   |    |          |
| CHECKED   |   |    |          |
| MFG. APPR.   |   |    |          |
| APPROVED   |   |    |          |
| DE APPR.   |   |    |          |
| DATE   | 13.01.21   |    |          |
| <b>DART AEROSPACE LTD</b><br>HAWKESBURY, ONTARIO, CANADA<br>DRAWING NO. <b>D3707</b> REV. D<br>SHEET 1 OF 3<br>TITLE <b>MOUNTING LUG</b> SCALE NTS<br><small>COPYRIGHT © 2008 BY DART AEROSPACE LTD<br/>THIS DOCUMENT IS PRIVATE AND CONFIDENTIAL AND IS NOT TO BE REPRODUCED OR COMMUNICATED TO ANY OTHER PERSON WITHOUT WRITTEN PERMISSION FROM DART AEROSPACE LTD.</small> |   |    |          |



**NOTES:**

- 1) MATERIAL: BLACK ACETRON GP ACETAL (REF DART SPEC M-DELIN-B)
- 2) FINISH: NONE
- 3) TOLERANCES: PER DART QSI 018 UNLESS OTHERWISE NOTED
- 4) UNITS: INCHES UNLESS OTHERWISE NOTED
- 5) BREAK SHARP EDGES: 0.005 TO 0.010 MAX
- 6) IDENTIFICATION: SCRIBE WITH DART P/N "D3707-X" AND B/N PER DART QSI 044 6.4 (VIBRATING STYLUS)
- 7) WEIGHT: D3707-1/-5 = 0.04 lbs APPROX  
D3707-3 = 0.07 lbs APPROX



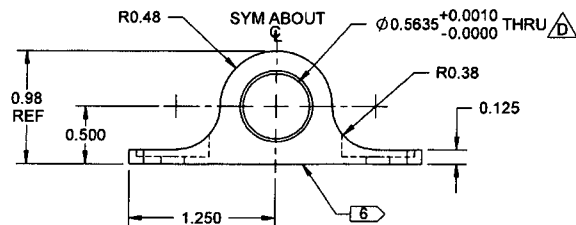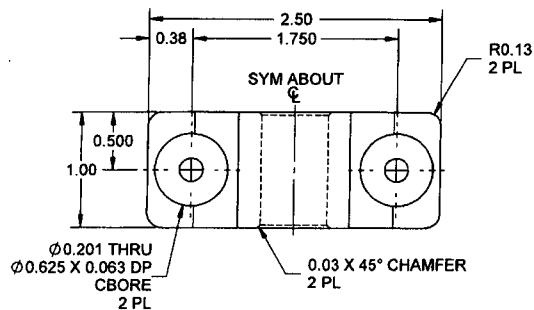


**D3707-1 MOUNTING LUG**

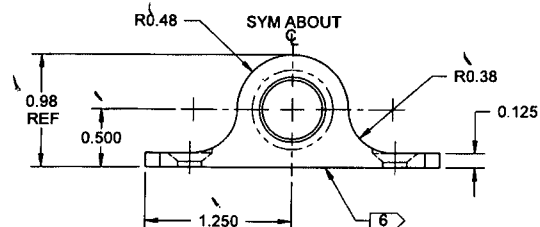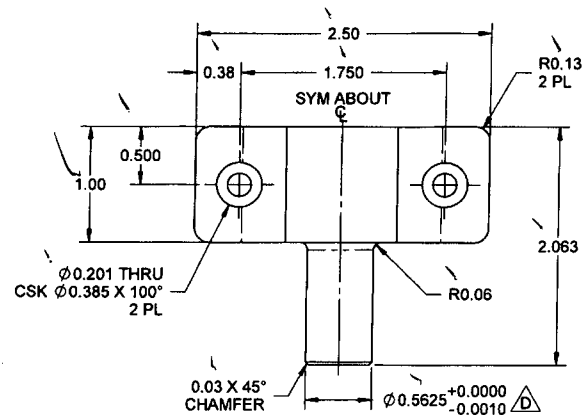


**D3707-3 MOUNTING LUG**

RELEASED  
2013-01-21

|            |          |   |              |
|------------|----------|---|--------------|
| DESIGN     | 1        | <b>DART AEROSPACE LTD</b>   |              |
| DRAWN      | 1        | HAWKESBURY, ONTARIO, CANADA   |              |
| CHECKED    | 1        | DRAWING NO.   | REV. D       |
| MFG. APPR. | 1        | <b>D3707</b>   | SHEET 2 OF 3 |
| APPROVED   | 1        | TITLE   | SCALE        |
| DE APPR.   | 1        | <b>MOUNTING LUG</b>   | NTS          |
| DATE       | 13.01.21 | <small>COPYRIGHT © 2008 BY DART AEROSPACE LTD<br/>THIS DOCUMENT IS PRIVATE AND CONFIDENTIAL AND IS SUPPLIED ON THE EXPRESS CONDITION THAT IT IS NOT TO BE USED FOR ANY PURPOSE OR COPIED OR COMMUNICATED TO ANY OTHER PERSON WITHOUT WRITTEN PERMISSION FROM DART AEROSPACE LTD.</small> |              |

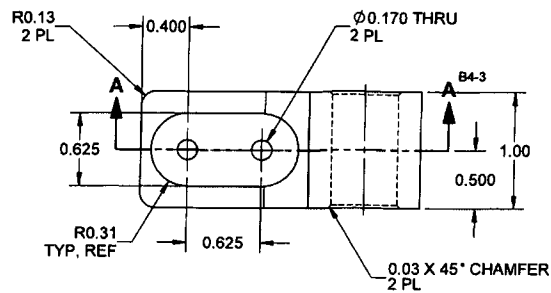

**D3707-5 MOUNTING LUG**

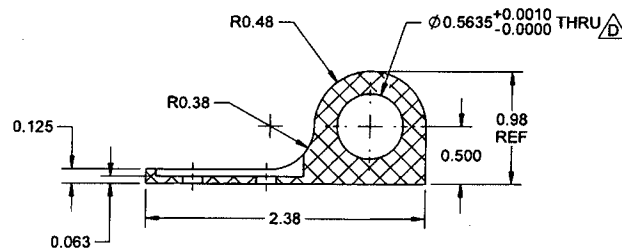

**SECTION A-A D4-3**

|            |                 |   |              |
|------------|-----------------|---|--------------|
| DESIGN     |                 | <b>DART AEROSPACE LTD</b>   |              |
| DRAWN      |                 | HAWKESBURY, ONTARIO, CANADA   |              |
| CHECKED    |                 | DRAWING NO.   | REV. D       |
| MFG. APPR. |                 | <b>D3707</b>   | SHEET 3 OF 3 |
| APPROVED   |                 | TITLE   | SCALE        |
| DE APPR.   |                 | <b>MOUNTING LUG</b>   | NTS          |
| DATE       | <b>13.01.21</b> | <small>COPYRIGHT © 2008 BY DART AEROSPACE LTD<br/>THIS DOCUMENT IS PRIVATE AND CONFIDENTIAL. NO DISSEMINATION OR REPRODUCTION OF ANY KIND IS PERMITTED WITHOUT THE WRITTEN PERMISSION FROM DART AEROSPACE LTD.</small> |              |